
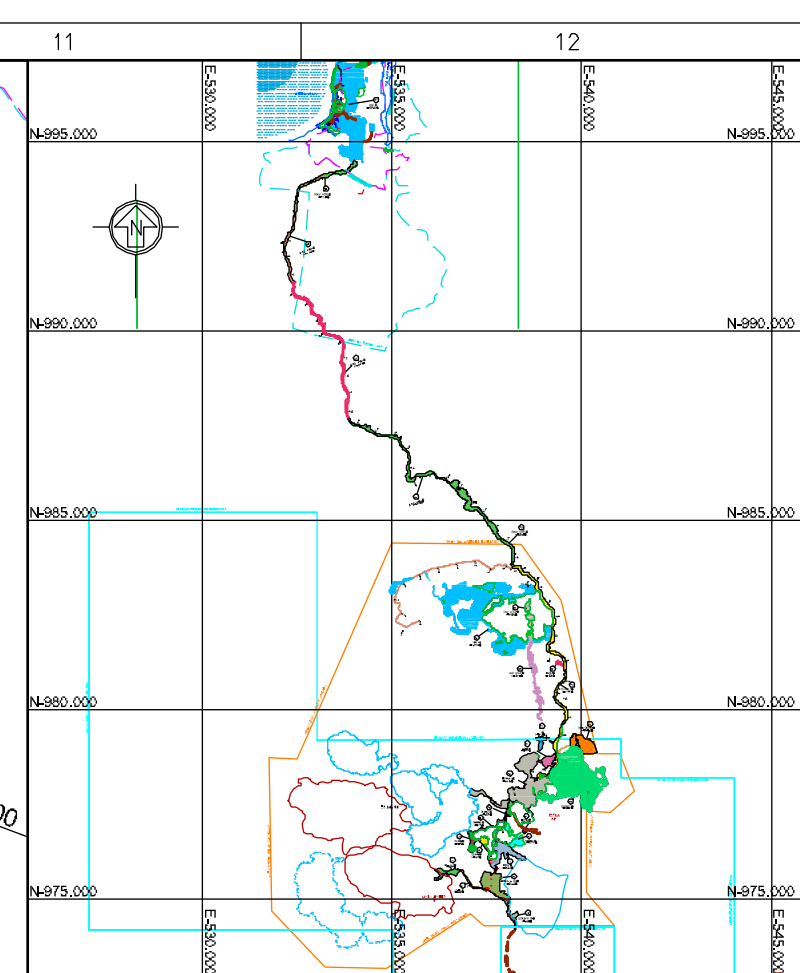
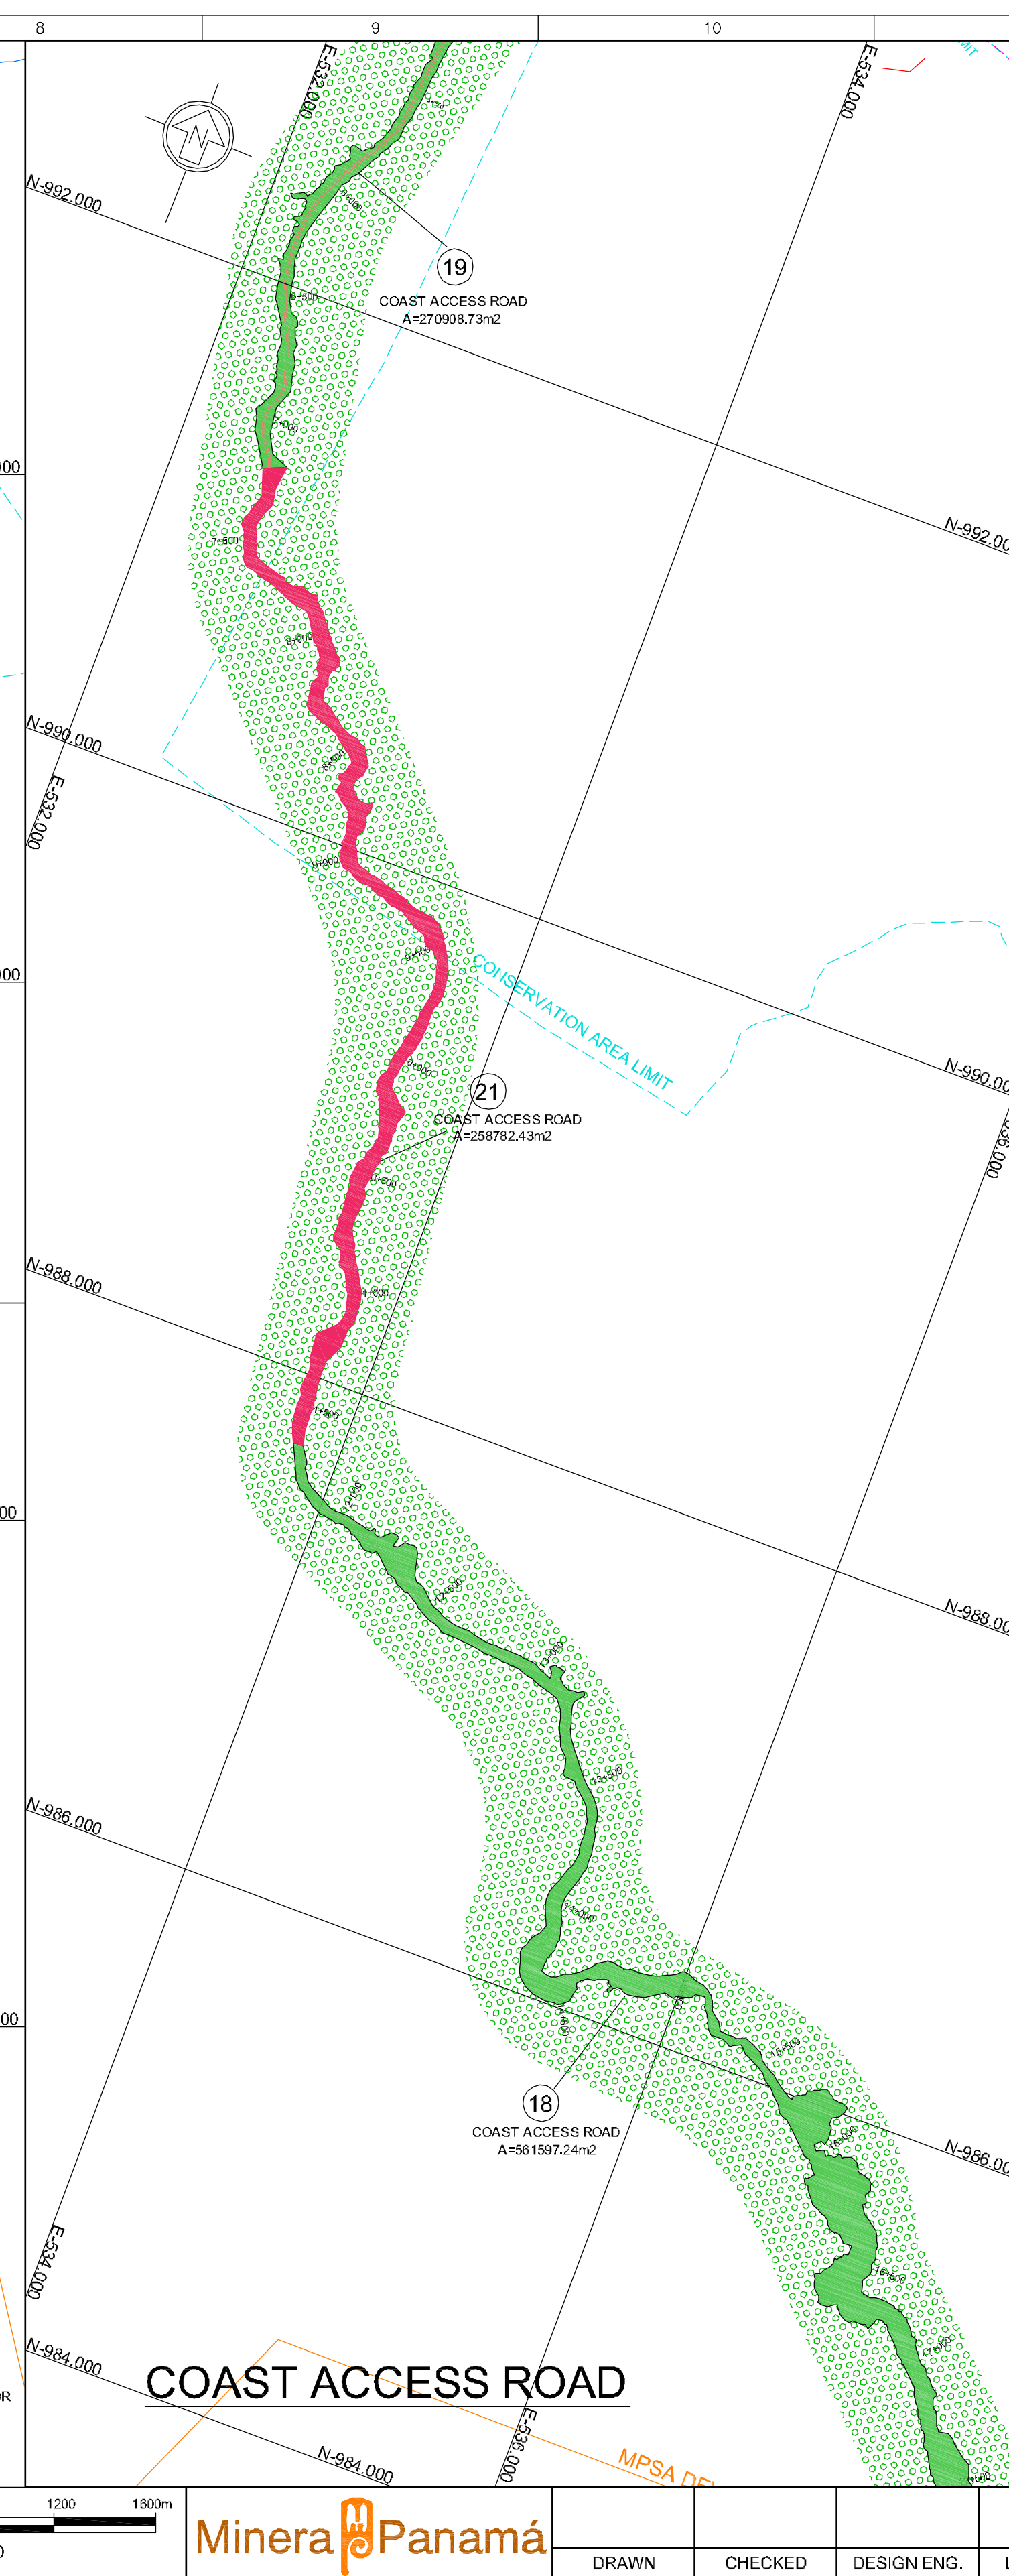
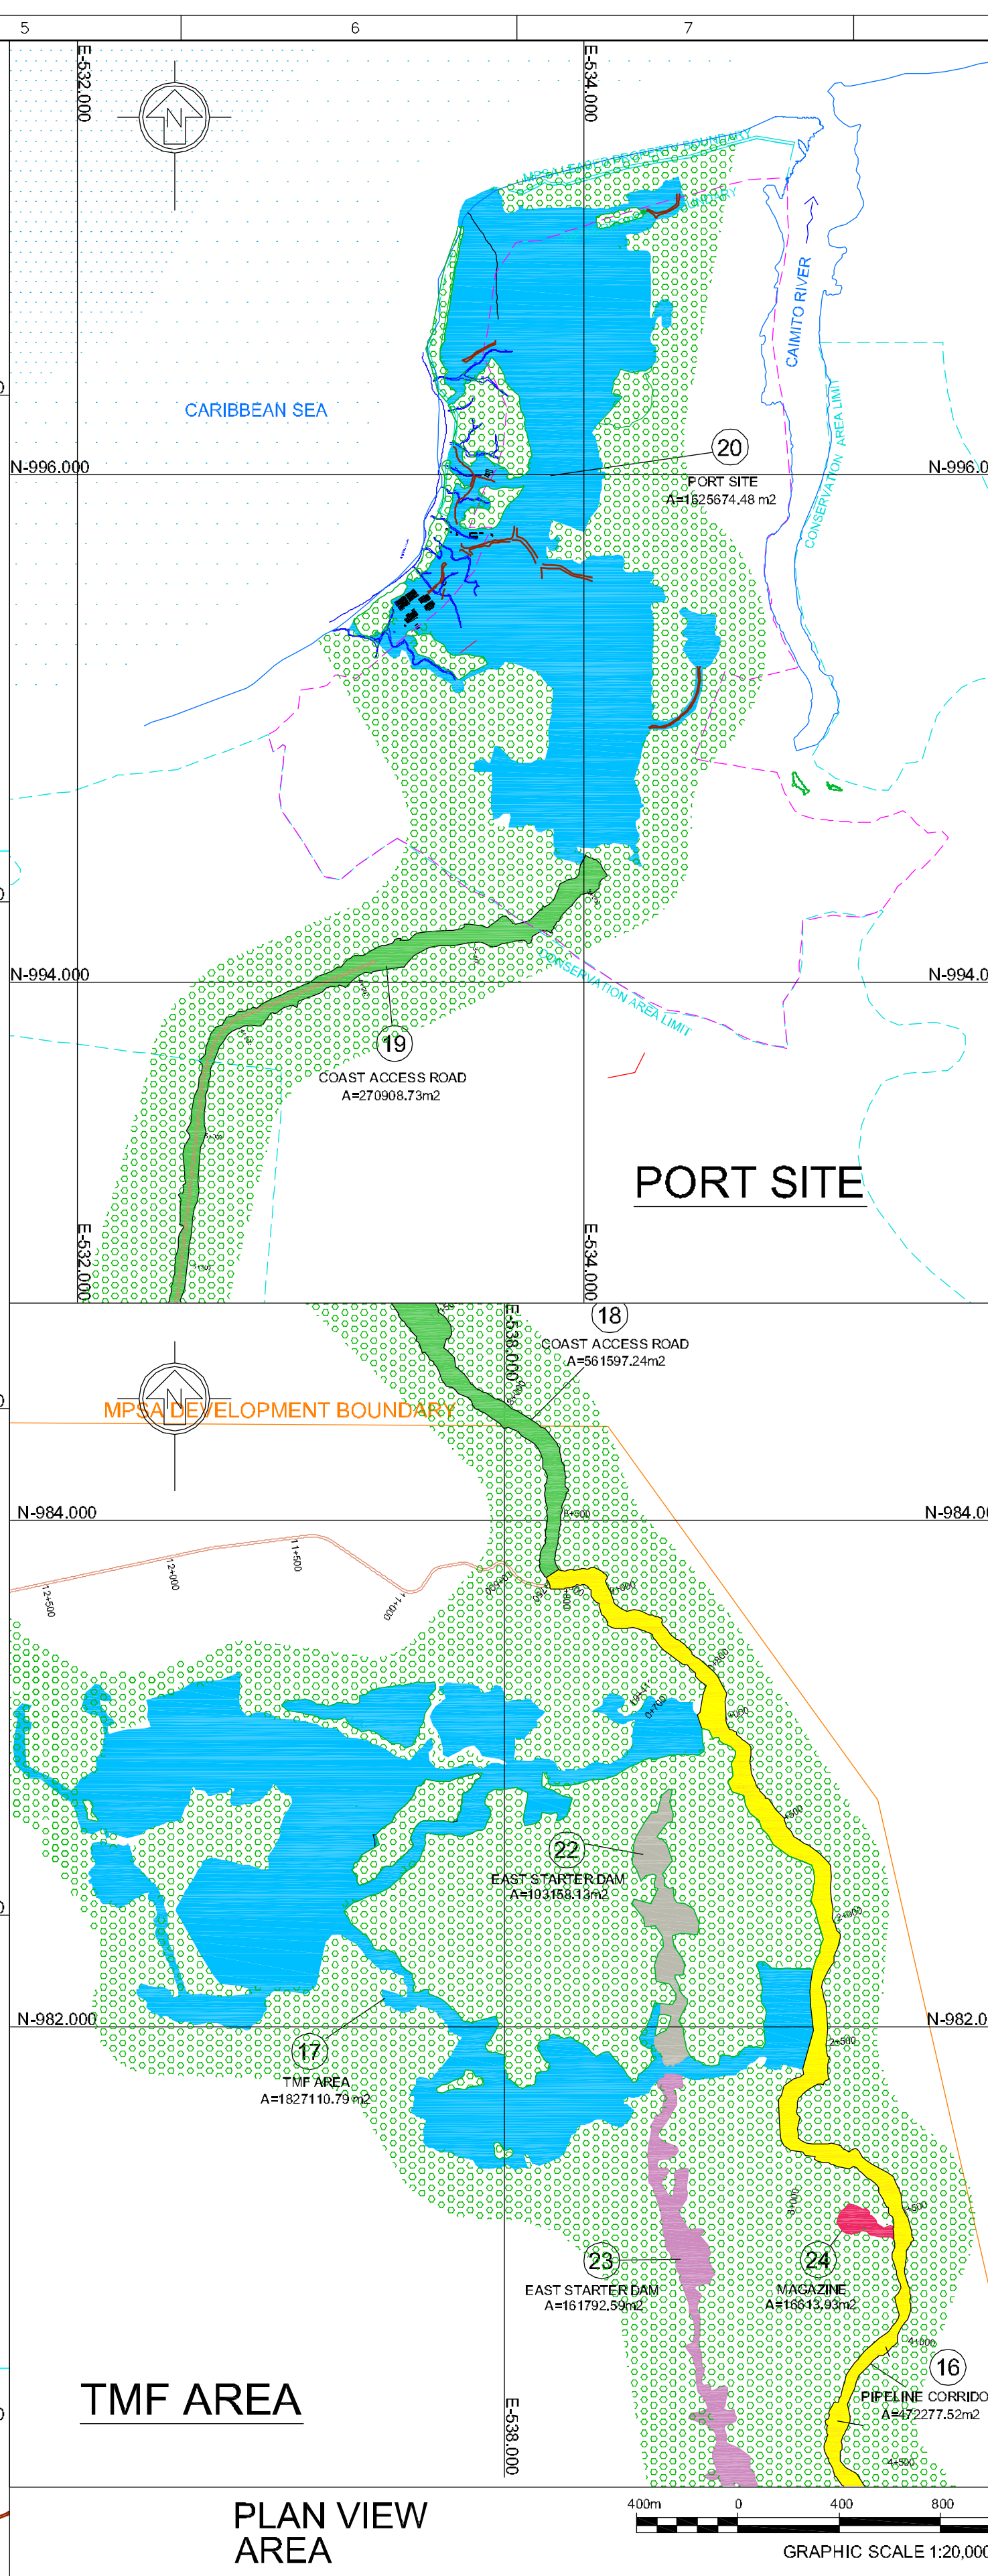


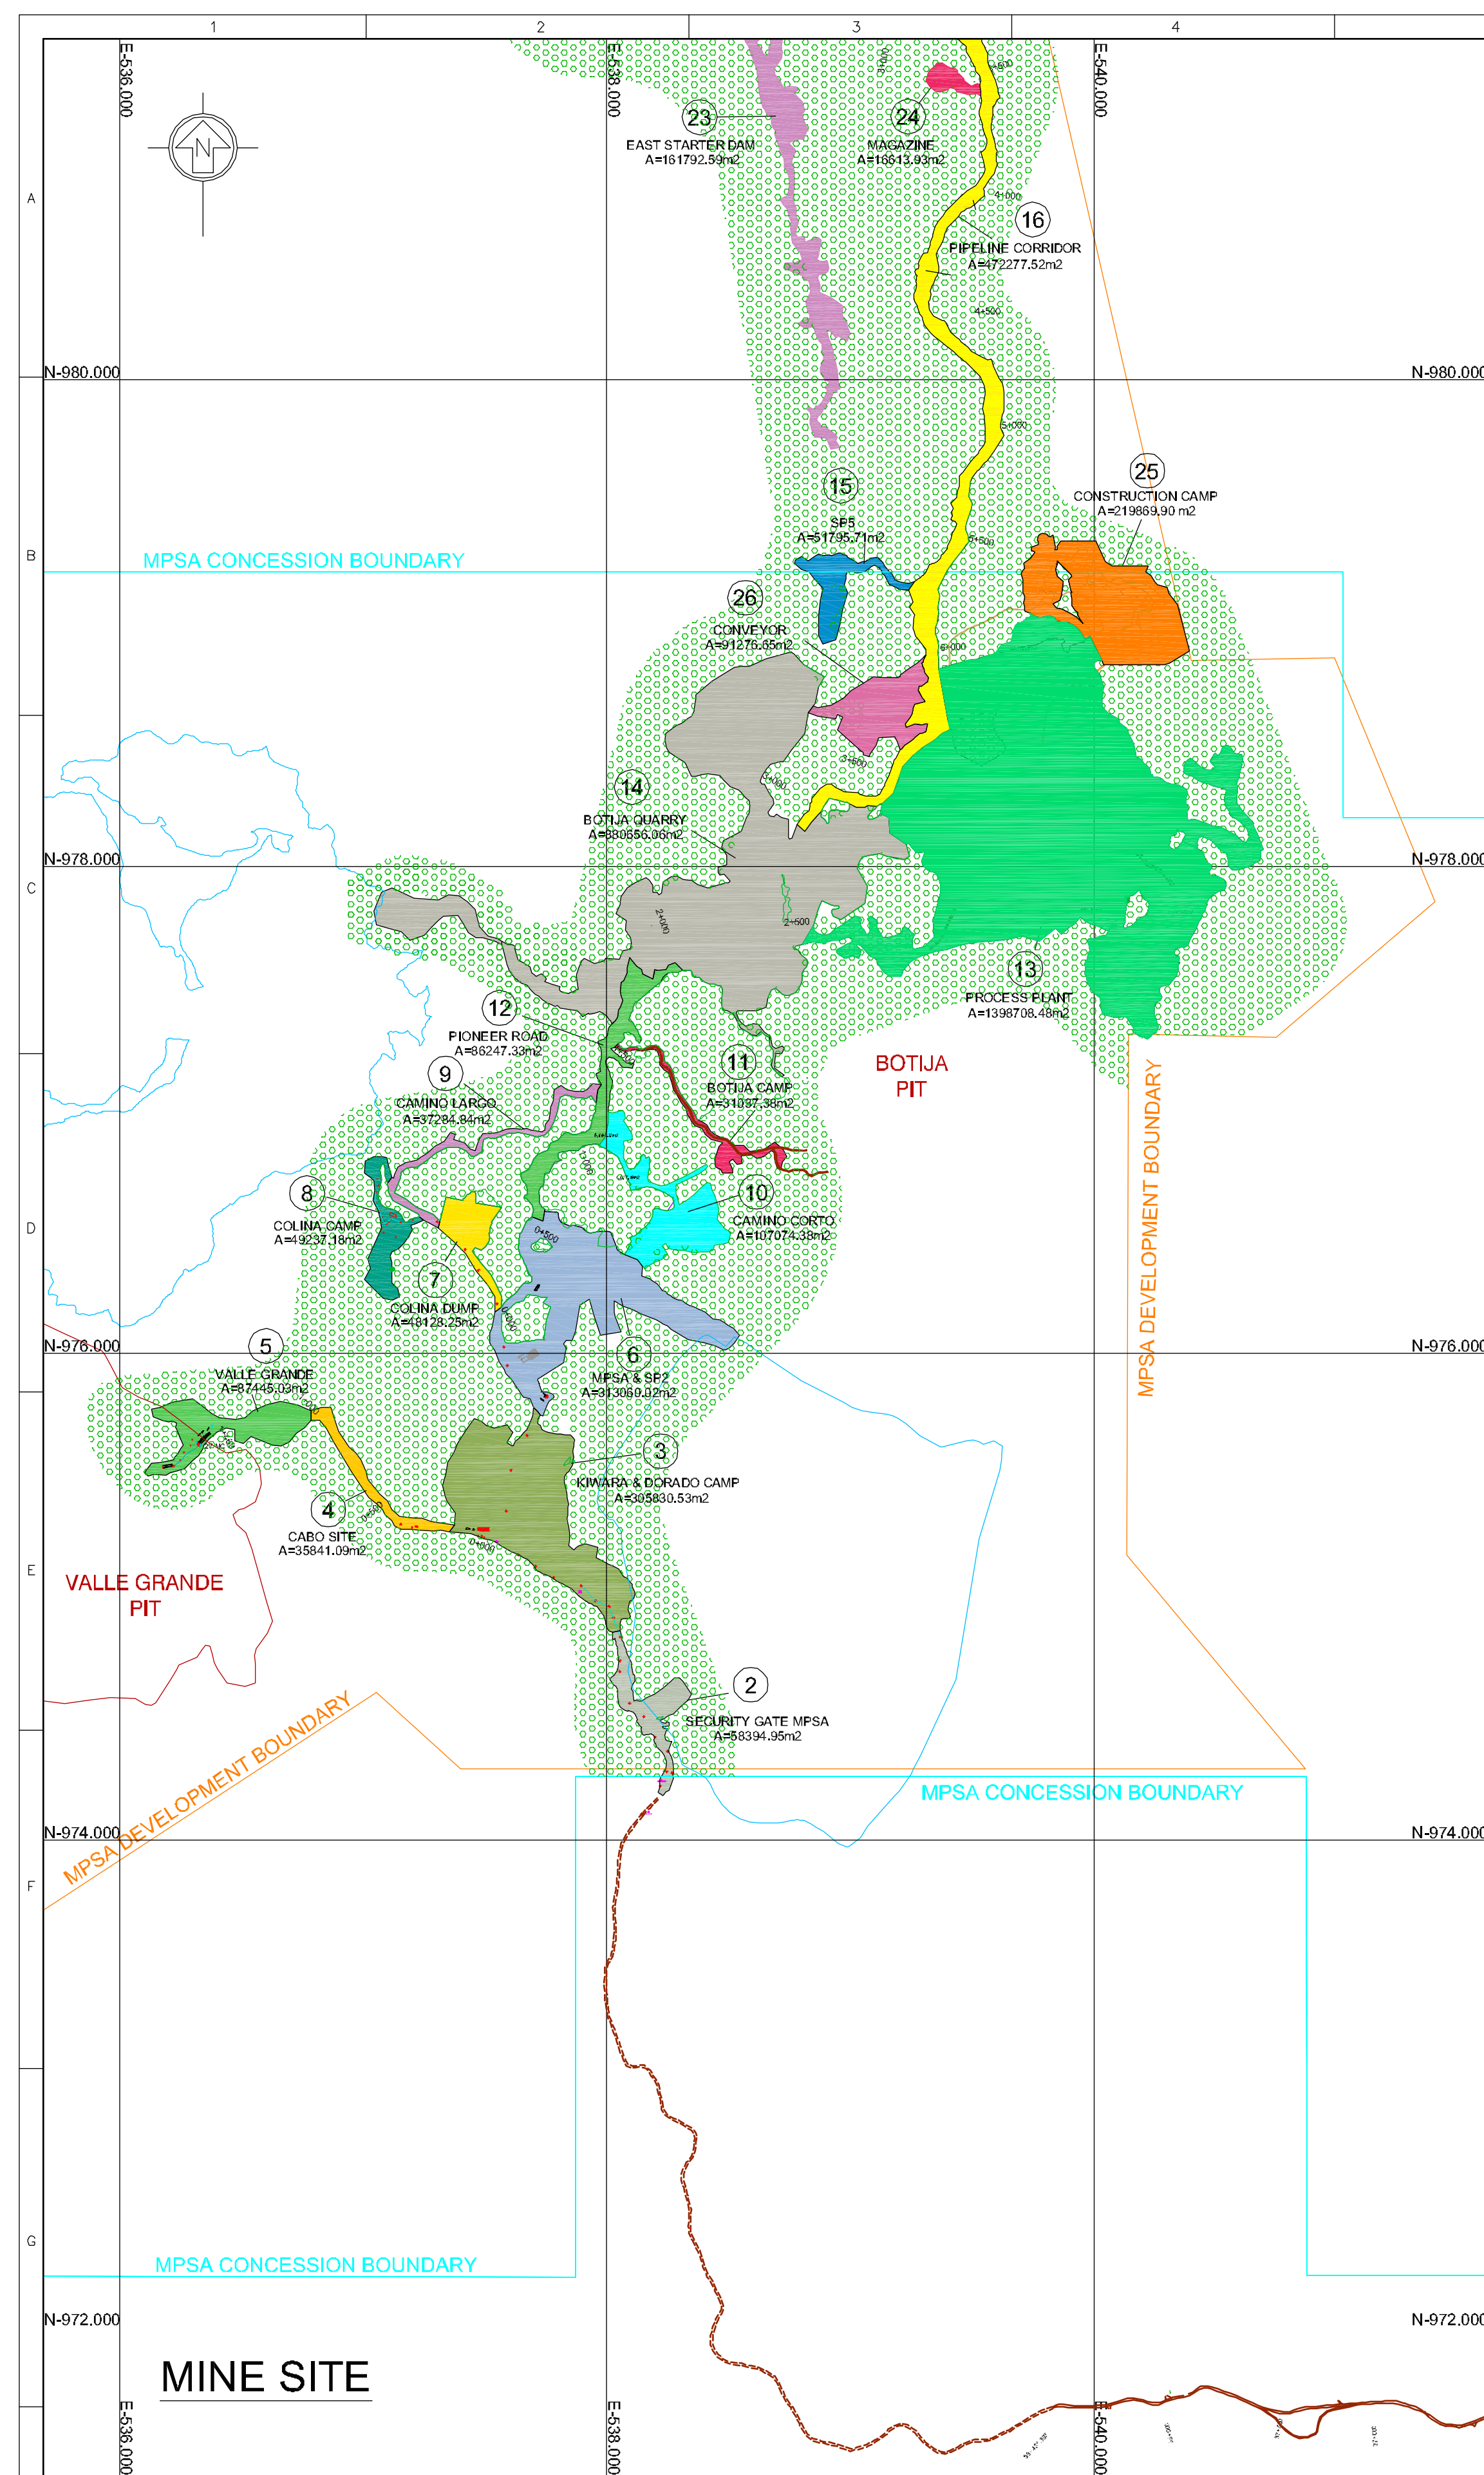

AUXILIARY CONTROL POINT

LEGEND

- ROAD
- POLYGON OF FOREST CLEARED
- POLYGON OF FOREST CLEARED
- POLYGON OF INFLUENCE OF WORKS
- MPSA CONCESSION BOUNDARY
- CONSERVATION AREA LIMIT

TABLE		
POLYGON OF FOREST CLEARED		
POLYGON	SITE	AREA
2	SECURITY GATE MPSA	5 Hect +8394.95 m2
3	KIWARA & DORADO CAMP	30 Hect +5830.53 m2
4	CABO SITE	3 Hect +5841.09 m2
5	VALLE GRANDE	8 Hect +7445.03 m2
6	MPSA & SP2	31 Hect +3060.02 m2
7	COLINA DUMP	4 Hect +8128.25 m2
8	COLINA CAMP	4 Hect +9237.18 m2
9	CAMINO LARGO	3 Hect +7284.84 m2
10	CAMINO CORTO	10 Hect +7074.38 m2
11	BOTIJA CAMP	3 Hect +1037.38 m2
12	PIONEER ROAD	8 Hect +6247.33 m2
13	PROCESS PLANT	139 Hect +8708.48 m2
14	BOTIJA QUARRY	88 Hect +0656.06 m2
15	SP5	5 Hect +1795.71 m2
16	PIPELINE CORRIDOR	47 Hect +2277.52 m2
18	COAST ACCESS ROAD	56 Hect +1597.24 m2
19	COAST ACCESS ROAD	27 Hect +0908.73 m2
20	PORT SITE	162 Hect +5674.48 m2
21	COAST ACCESS ROAD	25 Hect +8782.43 m2
22	EAST STARTER DAM	10 Hect +3158.13 m2
23	EAST STARTER DAM	16 Hect +1792.59 m2
24	MAGAZINE	1 Hect +6613.93 m2
25	CONSTRUCTION CAMP	21 Hect +9869.90 m2
26	CONVEYOR	9 Hect +1276.65 m2
TOTAL		913 Hect +3248.84 m2

NOTES:
1. ALL DIMENSIONS, ELEVATIONS AND GRID COORDINATES SHOWN ON THIS DRAWING ARE IN METERS. GRID SHOWN IS REFERENCED TO UTM WGS84 ZONE 17N DATUM.

										CLIENT										MPSA																				DRAWING TITLE COBRE PANAMA PROJECT FOREST CLEARED AREAS	
										PROJECT										MINA DE COBRE PANAMA										FIRST QUANTUM MINERALS LTD.	
										GENERAL PLAN										THIS DRAWING IS THE PROPERTY OF MINERA PANAMA S.A. (MPSA) AND THE USE AND COPYING THEREOF IS SUBJECT TO THE TERMS OF THE AGREEMENT UNDER WHICH IT WAS PREPARED. THIS DRAWING MAY NOT BE COPIED EXCEPT AS EXPRESSLY PROVIDED THEREIN.										SCALE 1:20,000										JOB No.										DRG No.										REV.	
																														00										23 / JAN / 2015										ASBUILT PLAN - POLYGON OF FOREST CLEARED										RCA	